




SOUTH EAST ELEVATION

SOUTH WEST ELEVATION

SOUTH EAST ELEVATION

NORTH WEST ELEVATION


ORIGINAL ELEVATIONS

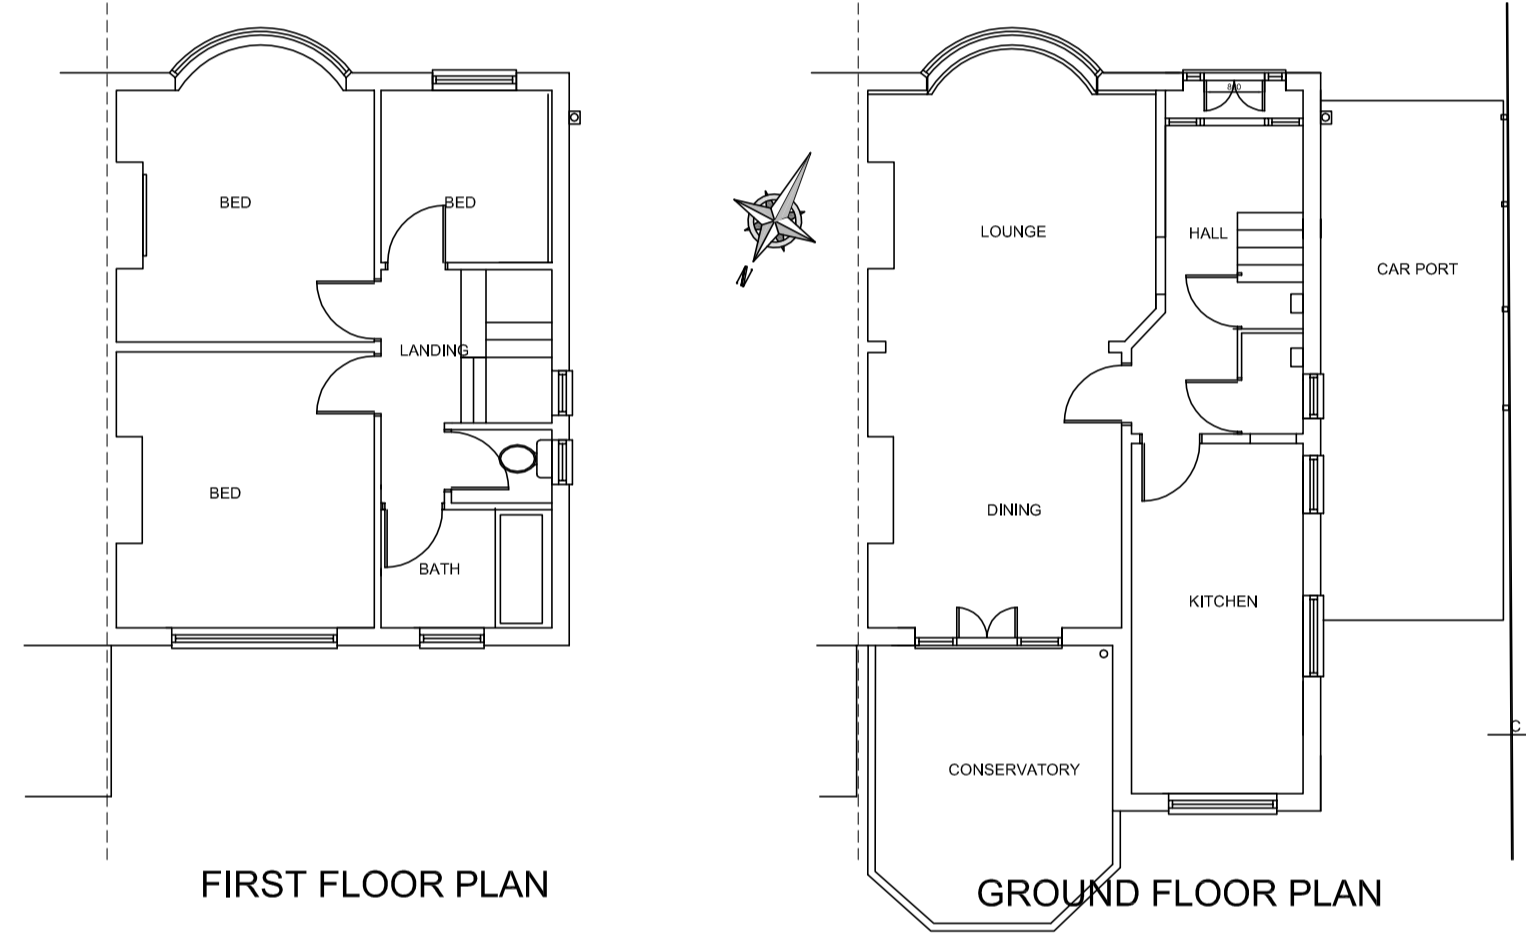

FIRST FLOOR PLAN

GROUND FLOOR PLAN

ORIGINAL PLANS

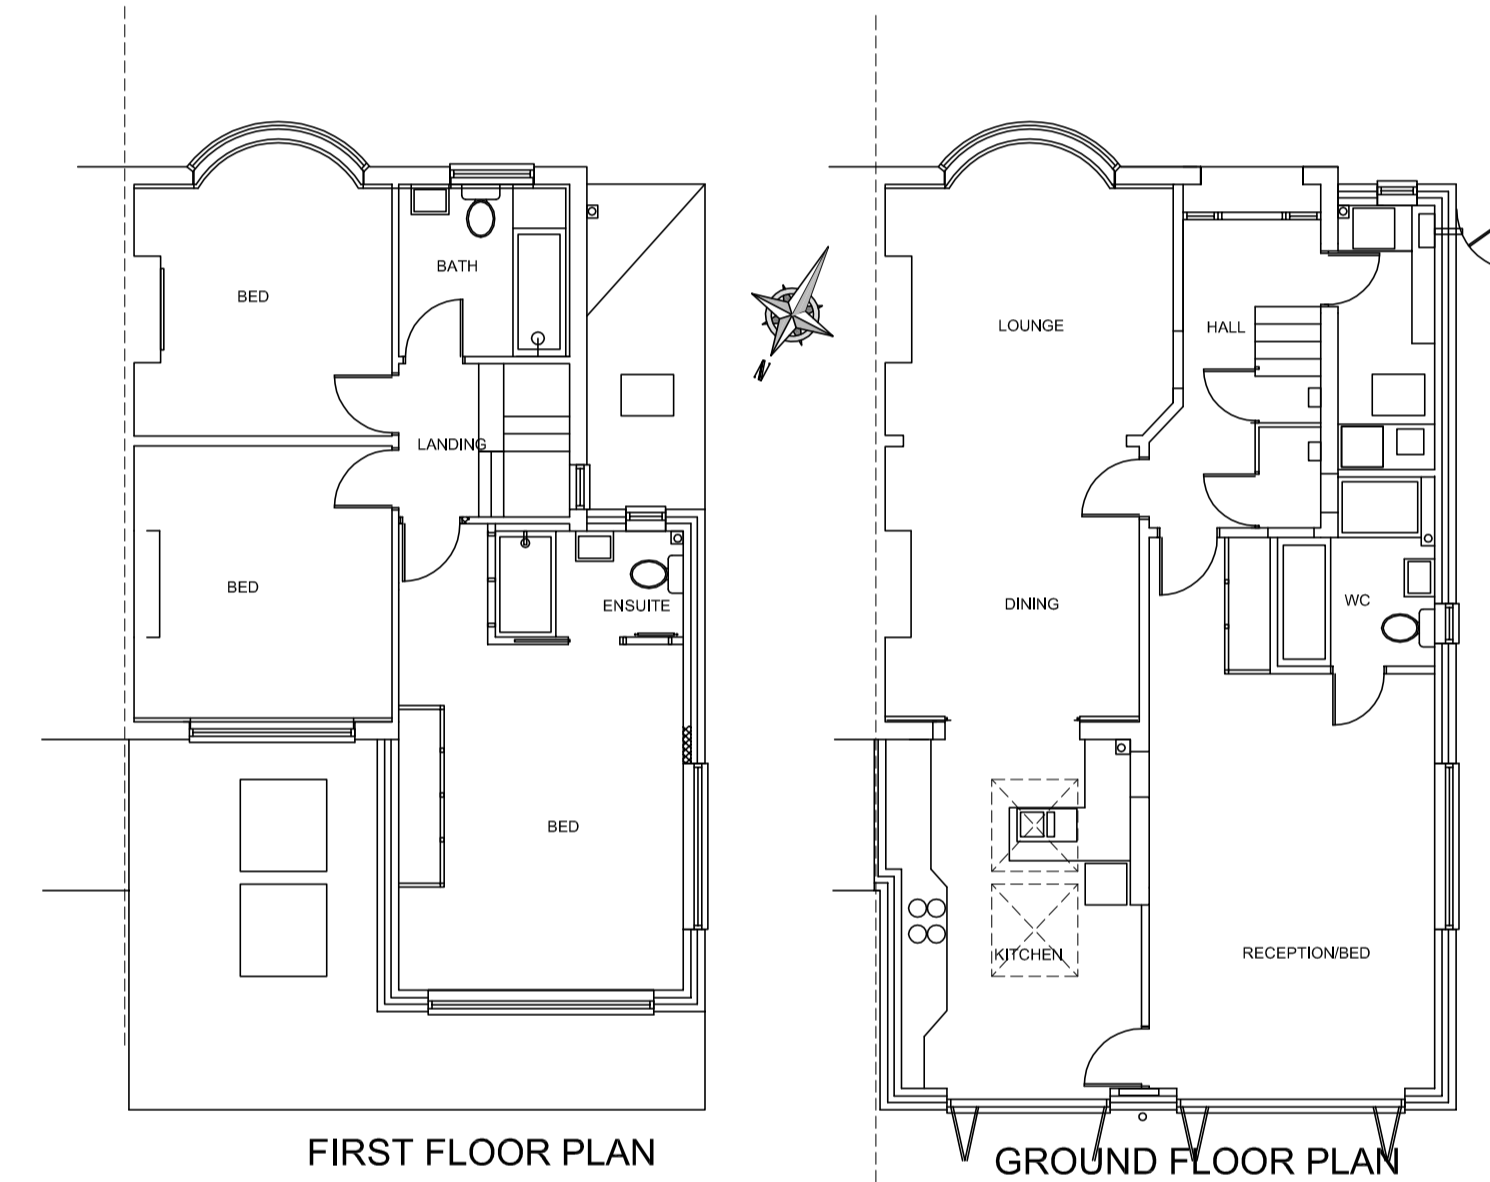


FIRST FLOOR PLAN

GROUND FLOOR PLAN

AS BUILT PLANS

AS CONSTRUCTED ELEVATIONS

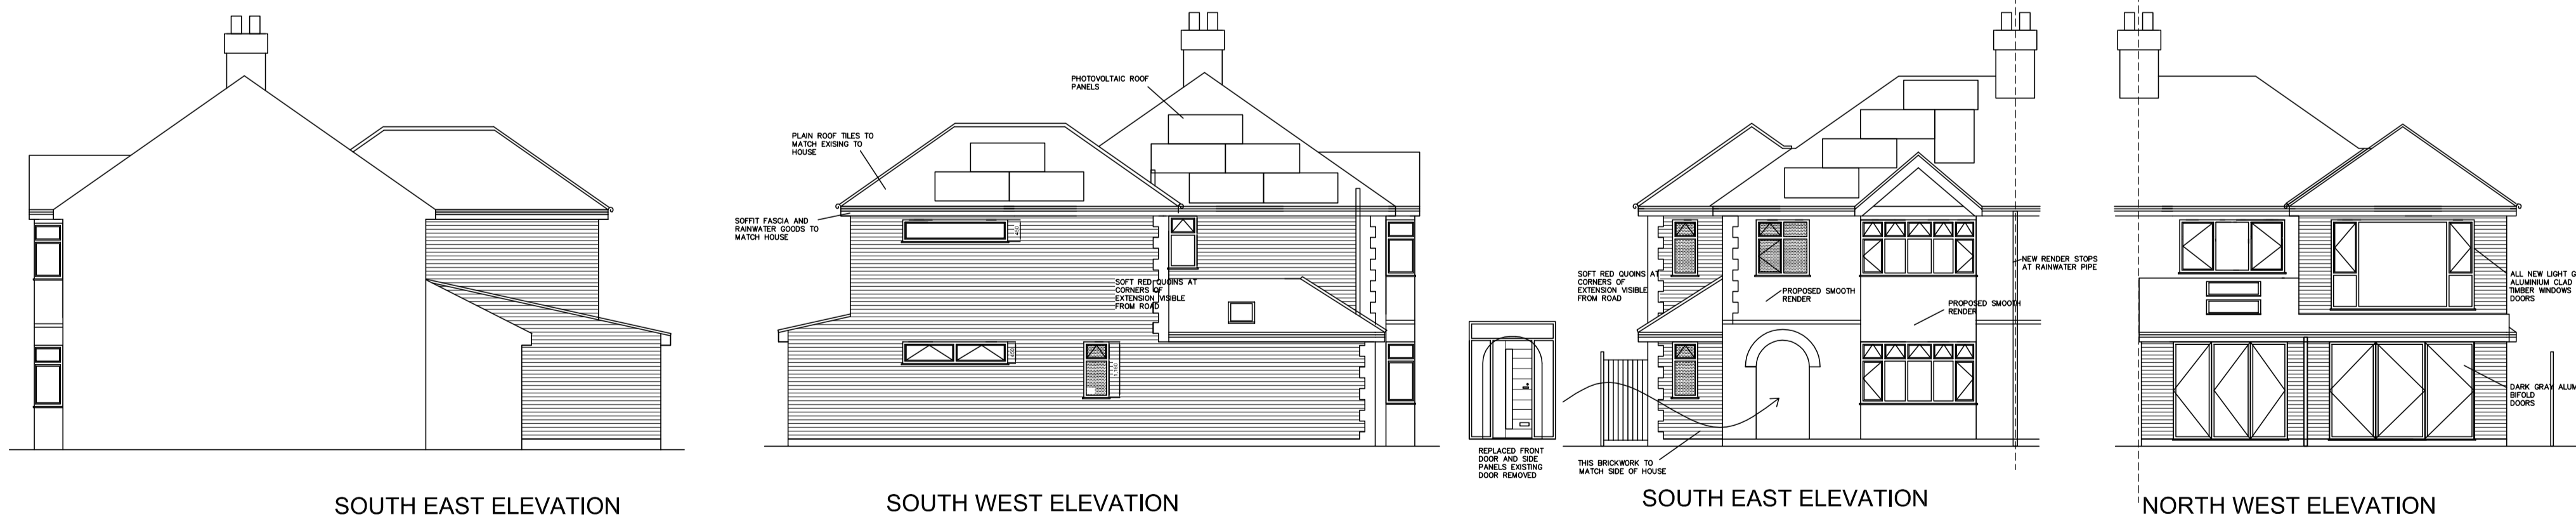

SOUTH EAST ELEVATION

SOUTH WEST ELEVATION

SOUTH EAST ELEVATION

NORTH WEST ELEVATION

ROOF PLAN