



Proposed Extensions at N^o
97, Perne Road, Cambridge
CB1 3SB.

Scale 1:100 @ A3.


Elevations and Section
as Built June 2014

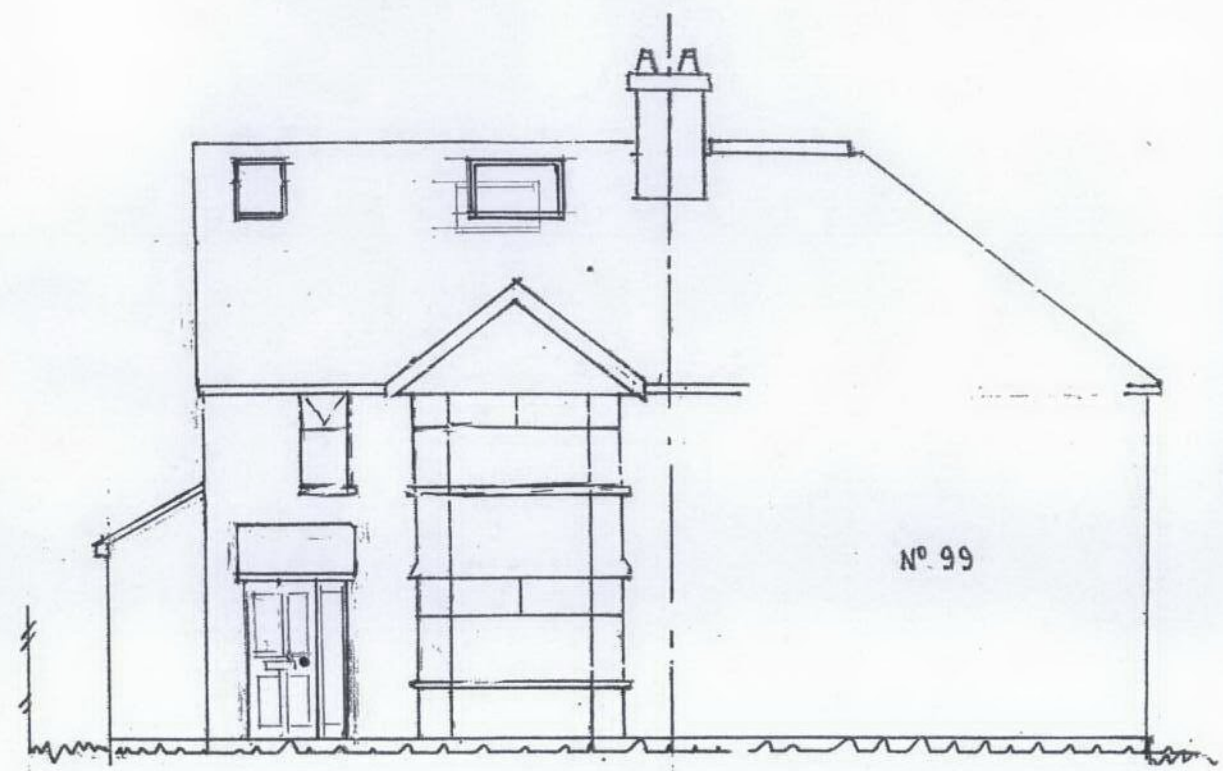


East Elevation

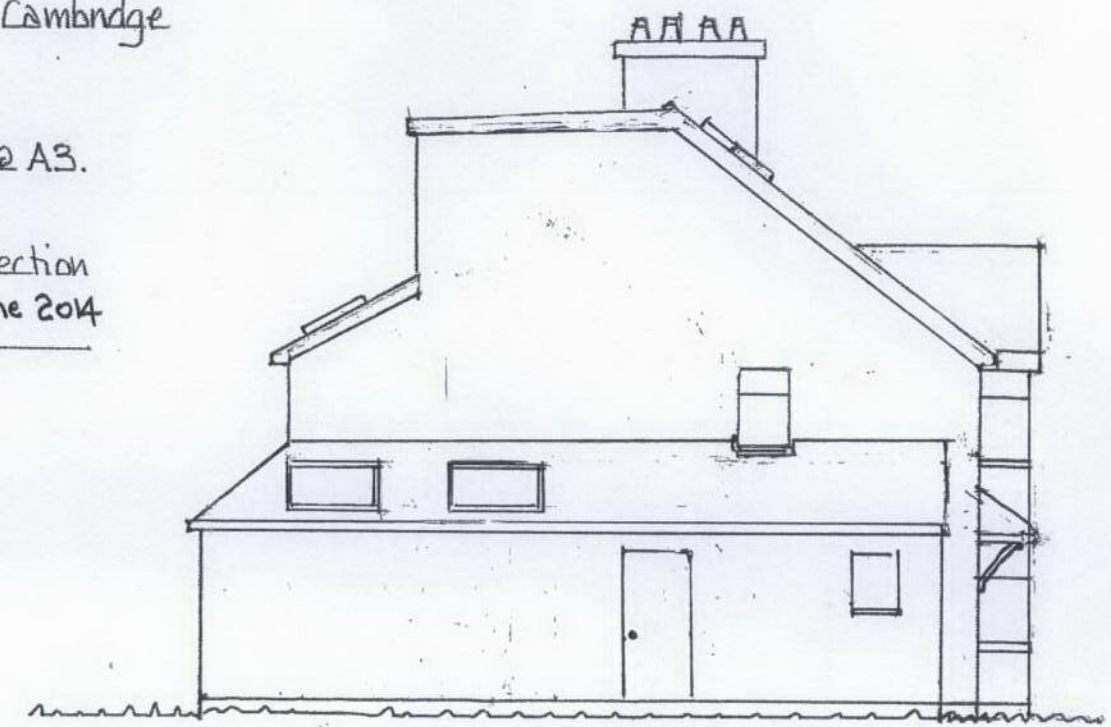


South Elevation.

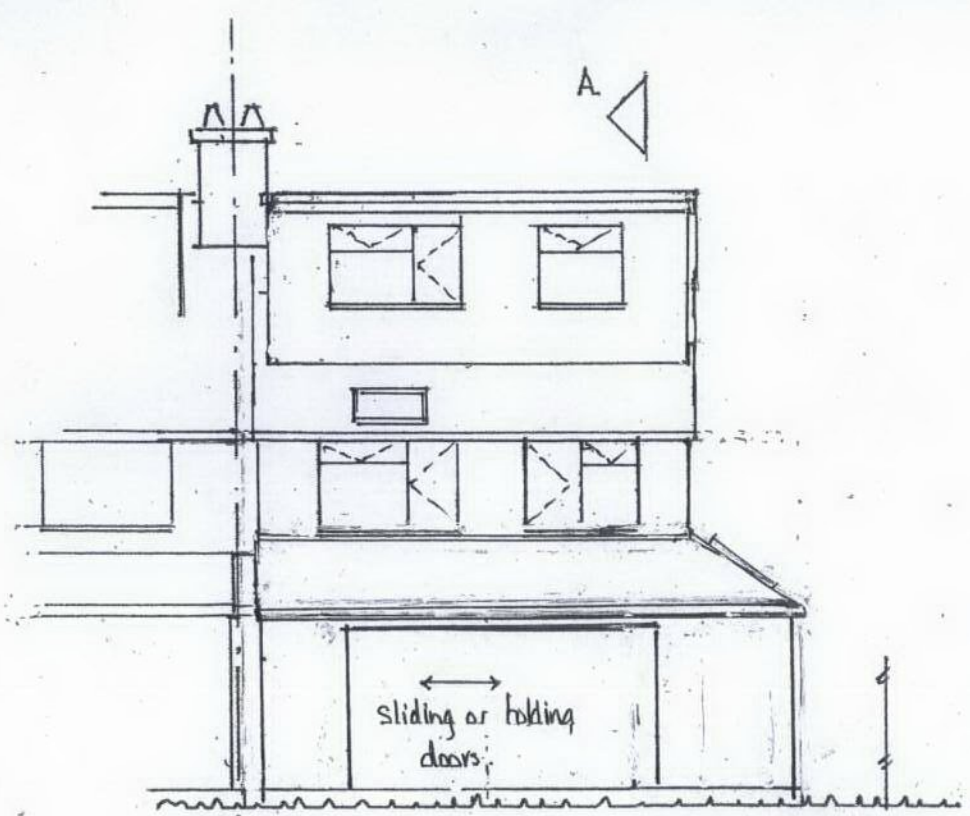

West Elevation

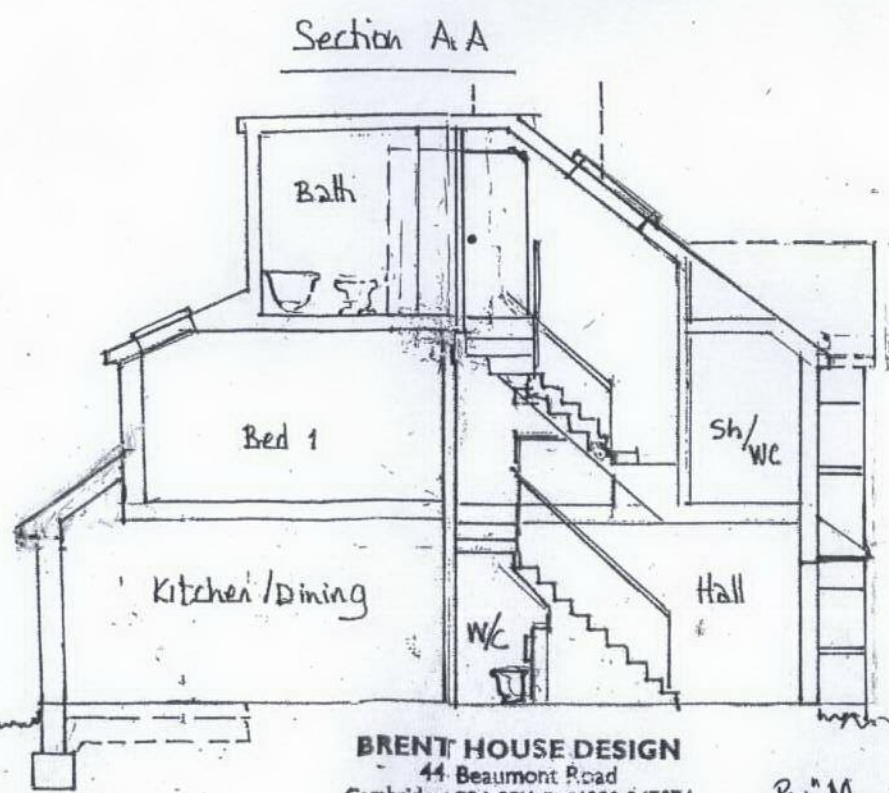

Section A-A

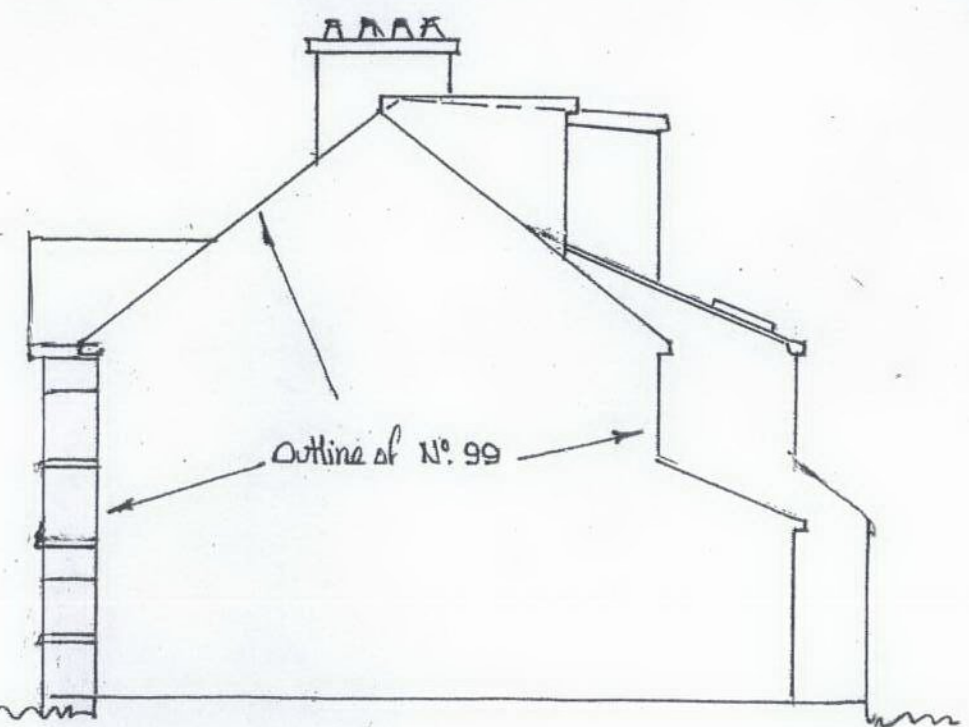

North Elevation

BRENT HOUSE DESIGN
44 Beaumont Road
Cambridge CB1 8PY ☎ 01223 247074
S. J. Hall M.I.C.E.
Chartered Civil Engineer

Rev M 22.10.12.
Rev N 17.6.14 as built